

Important: Read the instructions on pages 1 - 7.

SECTION A - PROPERTY OWNER INFORMATION

BUILDING OWNER'S NAME: JUAN VAN HUYNH  
 BUILDING STREET ADDRESS (including Apt. Unit, Suite, and/or Bldg No.) OR P.O. ROUTE AND BOX NO.: 217 INDIANA SE AFB NM 87104  
 CITY: AFB STATE: NM ZIP CODE: 87104

PROPERTY DESCRIPTION (Lot and Block Numbers, Tax Parcel Number, Legal Description, etc.):  
 BUILDING USE (e.g., Residential, Non-Residential, Addition, Accessory, etc. Use Comments section if necessary.):  
ALB1  
BLDG 14 A BLOCK #6 FAIRBROOKS ADD  
SEWERED MFG.

LATITUDE/LONGITUDE (OPTIONAL):  
 HORIZONTAL DATUM:  NAD 1927  NAD 1983 SOURCE:  GPS (Type):  USGS Quad Map  Other:  
 ( #° . #' . #'' or ##.#### )

SECTION B - FLOOD INSURANCE RATE MAP (FIRM) INFORMATION

B1. NFIP COMMUNITY NAME & COMMUNITY NUMBER: Albuquerque 350010 B2. COUNTY NAME: Bernalillo B3. STATE: New Mexico

B4. MAP AND PANEL NUMBER: 0354 B5. SUFFIX: D B6. FIRM INDEX DATE: 9/20/96 B7. FIRM PANEL EFFECTIVE/REVISED DATE: 9/20/96 B8. FLOOD ZONE(S): A0 B9. BASE FLOOD ELEVATION(S) (Zone AO, use depth of flooding): 11 foot

B10. Indicate the source of the Base Flood Elevation (BFE) data or base flood depth entered in B9.  
 FIS Profile  FIRM  Community Determined  Other (Describe):  
 B11. Indicate the elevation datum used for the BFE in B9:  NGVD 1929  NAVD 1988  Other (Describe):  
 B12. Is the building located in a Coastal Barrier Resources System (CBRS) area or Otherwise Protected Area (OPA)?  Yes  No  
 Designation Date: \_\_\_\_\_

SECTION C - BUILDING ELEVATION INFORMATION (SURVEY REQUIRED)


C1. Building elevations are based on:  Construction Drawings\*  Building Under Construction\*  Finished Construction  
 \*A new Elevation Certificate will be required when construction of the building is complete.  
 C2. Building Diagram Number: \_\_\_\_\_ (Select the building diagram most similar to the building for which this certificate is being completed - see pages 6 and 7. If no diagram accurately represents the building, provide a sketch or photograph.)  
 C3. Elevations - Zones A1-A30, AE, AH, A (with BFE), VE, V1-V30, V (with BFE), AR, ARA, ARAE, ARA1-A30, AR/AH, AR/AO  
 Complete items C3a-i below according to the building diagram specified in item C2. State the datum used. If the datum is different from the datum used for the BFE in Section B, convert the datum to that used for the BFE. Show field measurements and datum conversion calculation. Use the space provided or the Comments area of Section D or Section G, as appropriate, to document the datum conversion Datum: \_\_\_\_\_ Conversion/Comments: \_\_\_\_\_

Elevation reference mark used \_\_\_\_\_ Does the elevation reference mark used appear on the FIRM?  Yes  No

	ft. (m)	sq. in. (sq. cm)				
<input type="checkbox"/> a) Top of bottom floor (including basement or enclosure)	_____	_____	_____	_____	_____	_____
<input type="checkbox"/> b) Top of next higher floor	_____	_____	_____	_____	_____	_____
<input type="checkbox"/> c) Bottom of lowest horizontal structural member (V zones only)	_____	_____	_____	_____	_____	_____
<input type="checkbox"/> d) Attached garage (top of slab)	_____	_____	_____	_____	_____	_____
<input type="checkbox"/> e) Lowest elevation of machinery and/or equipment servicing the building	_____	_____	_____	_____	_____	_____
<input type="checkbox"/> f) Lowest adjacent grade (LAG)	_____	_____	_____	_____	_____	_____
<input type="checkbox"/> g) Highest adjacent grade (HAG)	_____	_____	_____	_____	_____	_____
<input type="checkbox"/> h) No. of permanent openings (flood vents) within 1 ft. above adjacent grade	_____	_____	_____	_____	_____	_____
<input type="checkbox"/> i) Total area of all permanent openings (flood vents) in C3h	_____	_____	_____	_____	_____	_____

SECTION D - SURVEYOR, ENGINEER, OR ARCHITECT CERTIFICATION

This certification is to be signed and sealed by a land surveyor, engineer, or architect authorized by law to certify elevation information. I understand that the information in Sections A, B, and C on this certificate represents my best efforts to interpret the data available. I understand that any false statement may be punishable by fine or imprisonment under 18 U.S. Code, Section 1001.

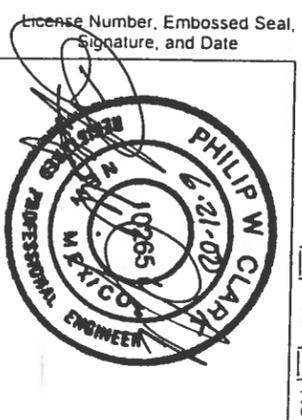

CERTIFIER'S NAME: Philip W. Clark LICENSE NUMBER: NM # 10265

TITLE: Owner  
 ADDRESS: 19 Ryan Rd. CITY: Edgewood STATE: NM ZIP CODE: 87015  
 SIGNATURE: [Signature] DATE: 6-21-00 TELEPHONE: 505-281-2444

IMPORTANT: In these spaces, copy the corresponding information from Section A.

BUILDING STREET ADDRESS (Including Apt., Unit, Suite, and/or Bldg. No.) OR P.O. ROUTE AND BOX NO. 217 INDIANA ST For Insurance Company Use

CITY ALBUQUERQUE STATE NM 87107 Policy Number

SECTION D - SURVEYOR, ENGINEER, OR ARCHITECT CERTIFICATION (CONTINUED) ZIP CODE 87107 Company NAIC Number

Copy both sides of this Elevation Certificate for (1) community official, (2) insurance agent/company, and (3) building owner.

COMMENTS  
Benchmark Datum: 11600. Control Survey, alum. cap stamped  
11-K19 A, MSU Elev 5308.58 @ NWE curb Louisiana Blvd.  
1 Zuni Rd., See attached sketch

SECTION E - BUILDING ELEVATION INFORMATION (SURVEY NOT REQUIRED) FOR ZONE AO AND ZONE A (WITHOUT BFE)  
 Check here if attachments

For Zone AO and Zone A (without BFE), complete items E1 through E4. If the Elevation Certificate is intended for use as supporting information for a LOMA or LOMR-F, Section C must be completed.

E1 Building Diagram Number 1 (Select the building diagram most similar to the building for which this certificate is being completed - see pages 6 and 7. If no diagram accurately represents the building, provide a sketch or photograph.)

E2 The top of the bottom floor (including basement or enclosure) of the building is  ft. (m) 42 in. (cm)  above or  below (check one) the highest adjacent grade.

For Building Diagrams 6-8 with openings (see page 7), the next higher floor or elevated floor (elevation b) of the building is  ft. (m)  in. (cm) above the highest adjacent grade.

E4 For Zone AO only: If no flood depth number is available, is the top of the bottom floor elevated in accordance with the community's floodplain management ordinance?  Yes  No  Unknown. The local official must certify this information in Section G.

SECTION F - PROPERTY OWNER (OR OWNER'S REPRESENTATIVE) CERTIFICATION

The property owner or owner's authorized representative who completes Sections A, B, and E for Zone A (without a FEMA-issued or community-issued BFE) or Zone AO must sign here

PROPERTY OWNER'S OR OWNER'S AUTHORIZED REPRESENTATIVE'S NAME LUAN YUAN HUYNH

ADDRESS 1510 A WYOMING AVE CITY ALBUQUERQUE, STATE NEW MEXICO ZIP CODE 87112

SIGNATURE Luan Yuan Huynh DATE 6/15/2002 TELEPHONE 505-332-6000

COMMENTS  
 Check here if attachments

SECTION G - COMMUNITY INFORMATION (OPTIONAL)

The local official who is authorized by law or ordinance to administer the community's floodplain management ordinance can complete Sections A, B, C (or E), and G of this Elevation Certificate. Complete the applicable item(s) and sign below.

G1  The information in Section C was taken from other documentation that has been signed and embossed by a licensed surveyor, engineer, or architect who is authorized by state or local law to certify elevation information. (Indicate the source and date of the elevation data in the Comments area below.)

G2  A community official completed Section E for a building located in Zone A (without a FEMA-issued or community-issued BFE) or Zone AO.

G3  The following information (Items G4-G9) is provided for community floodplain management purposes.

G4 PERMIT NUMBER \_\_\_\_\_ G5 DATE PERMIT ISSUED \_\_\_\_\_ G6 DATE CERTIFICATE OF COMPLIANCE/OCCUPANCY ISSUED \_\_\_\_\_

G7 This permit has been issued for:  New Construction  Substantial Improvement

G8 Elevation of as-built lowest floor (including basement) of the building is: \_\_\_\_\_ ft. (m) Datum: \_\_\_\_\_


G9 BFE or (in Zone AO) depth of flooding at the building site is \_\_\_\_\_ ft. (m) Datum: \_\_\_\_\_

LOCAL OFFICIAL'S NAME \_\_\_\_\_ TITLE \_\_\_\_\_

COMMUNITY NAME \_\_\_\_\_ TELEPHONE \_\_\_\_\_

SIGNATURE \_\_\_\_\_ DATE \_\_\_\_\_

COMMENTS \_\_\_\_\_

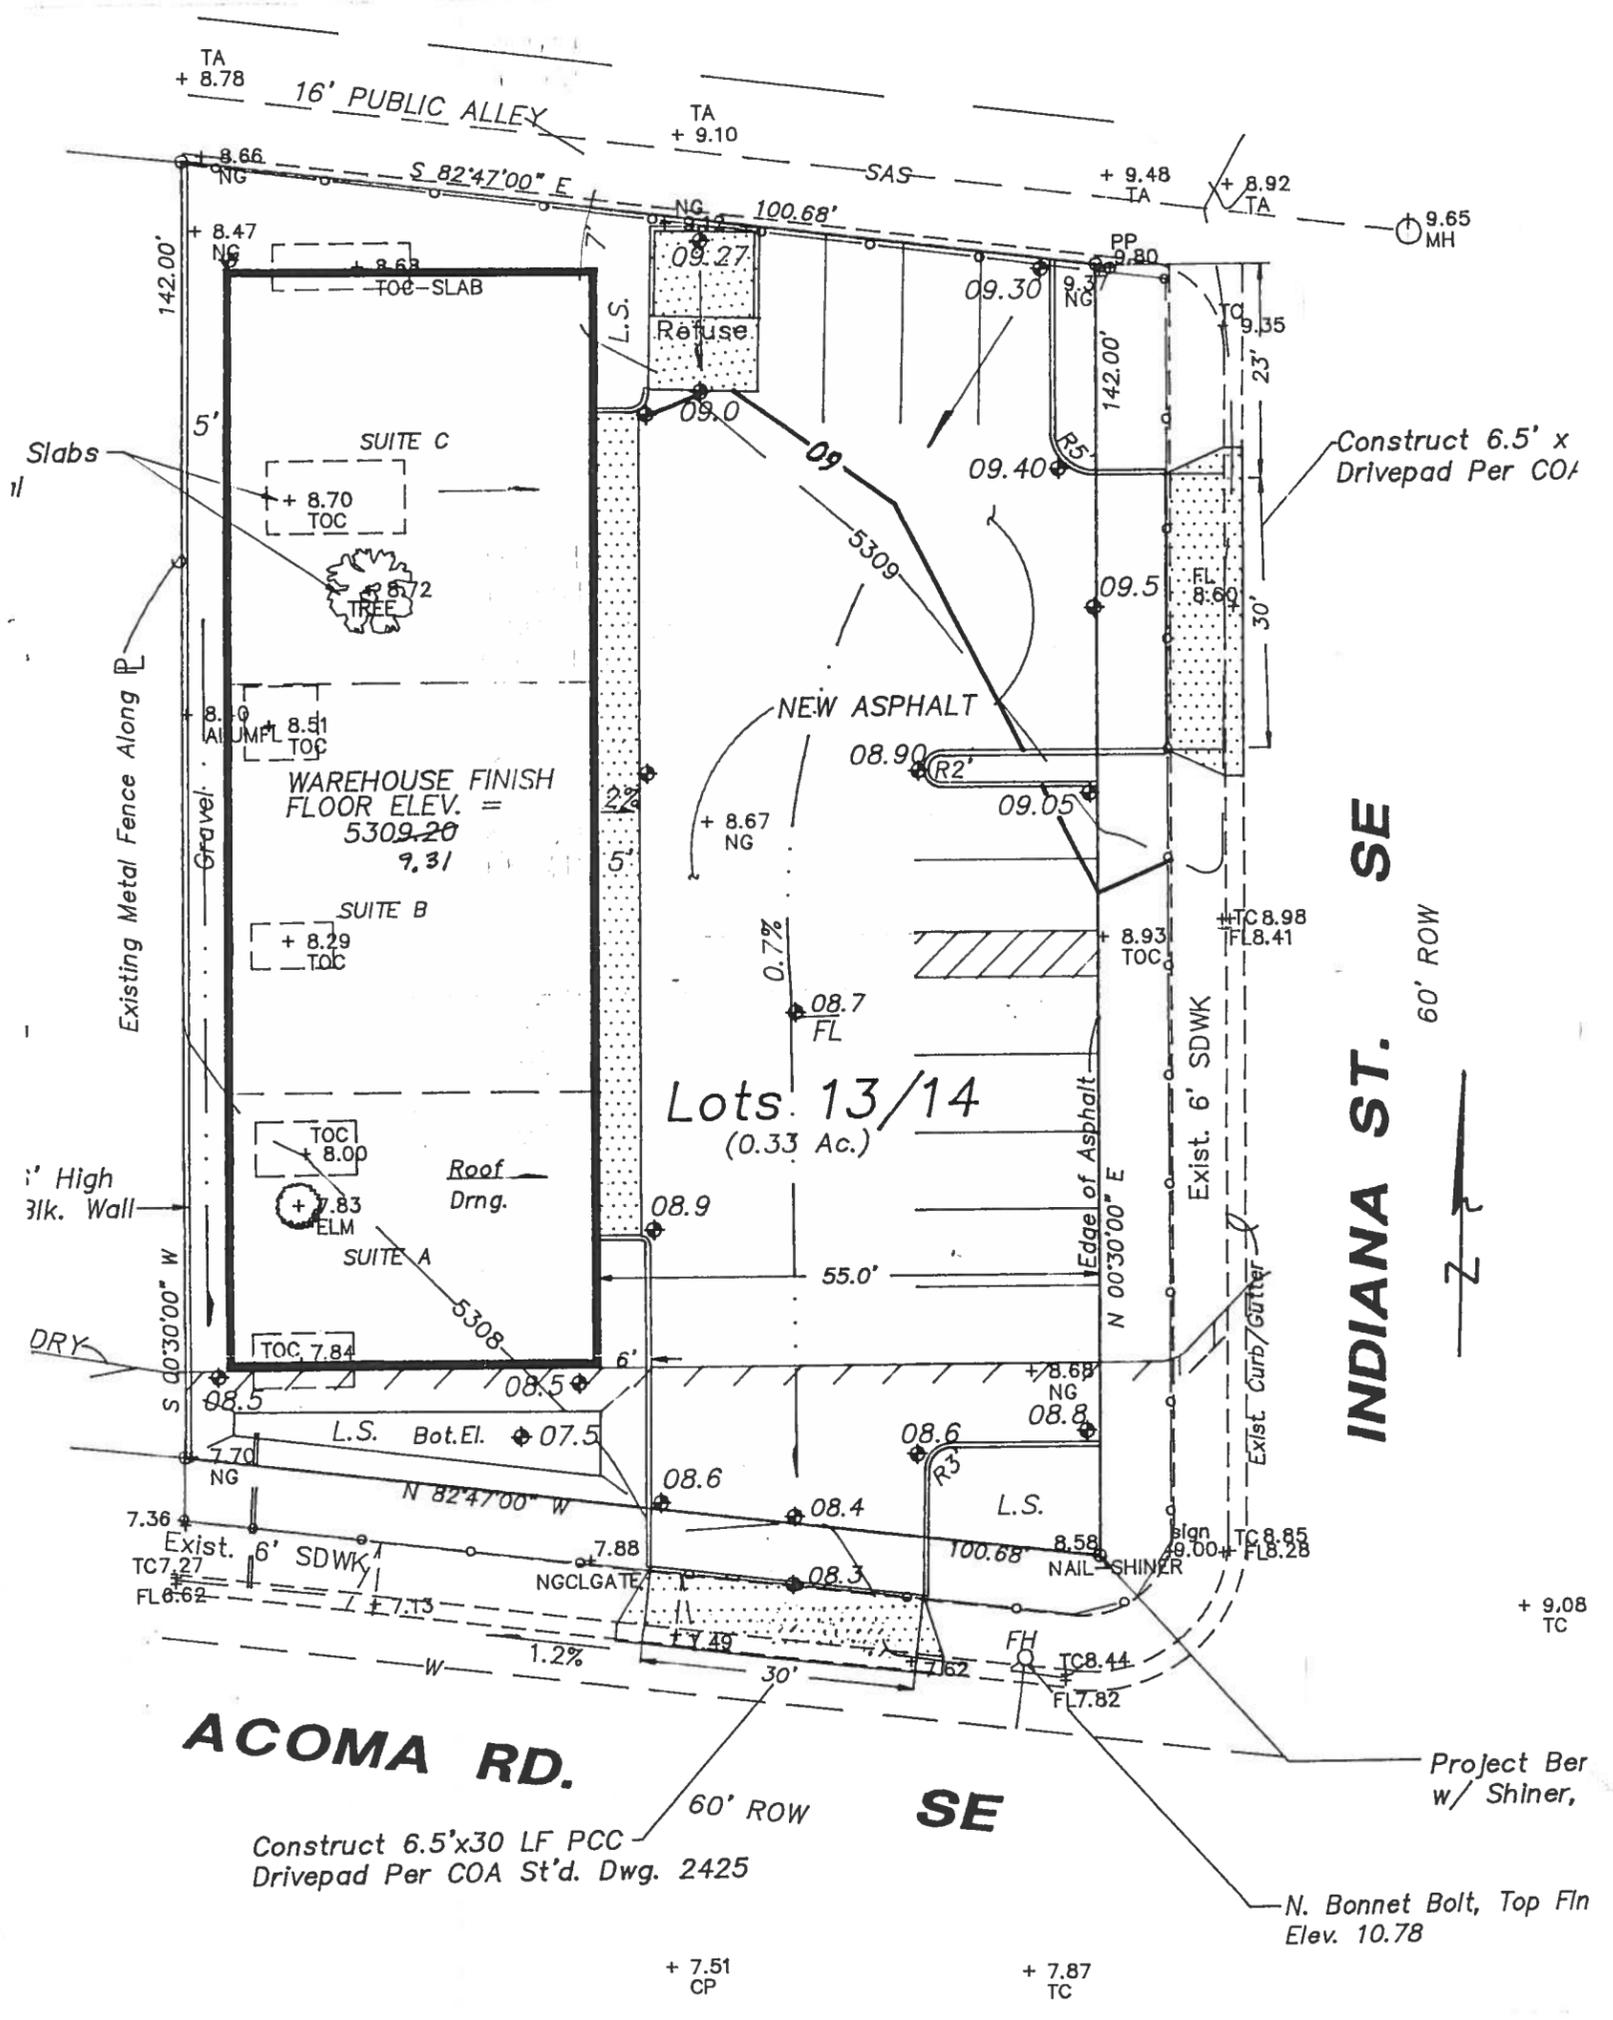

I, PHILIP W. CLARK, A PROFESSIONAL ENGINEER LICENSED IN ACCORDANCE WITH THE LAWS OF NEW MEXICO, DO HEREBY CERTIFY THAT I HAVE VISITED THE SITE SHOWN HEREON, AND THAT THE SHOWN REPRESENT THE EXISTING GROUND CONDITIONS, AND DO FURTHER CERTIFY THAT NO EARTHWORK OF ANY KIND, NOR ANY DISTURBANCE OF THE EXISTING GROUND HAS OCCURRED ON THIS SITE SINCE THE CONDITIONS WERE DETERMINED.

*Philip W. Clark*  
 PHILIP W. CLARK 10/12/99  
 NMPE #10263

Scale: 1"=20'  
 Ref. Building Diagram #1